



700 Canal Street Stamford, CT Tower

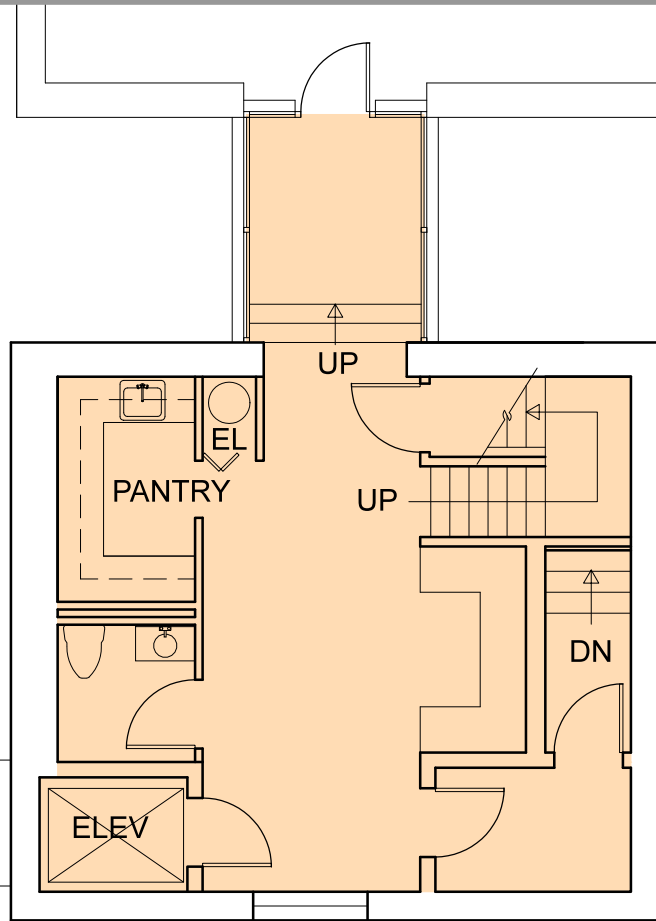

6th Floor

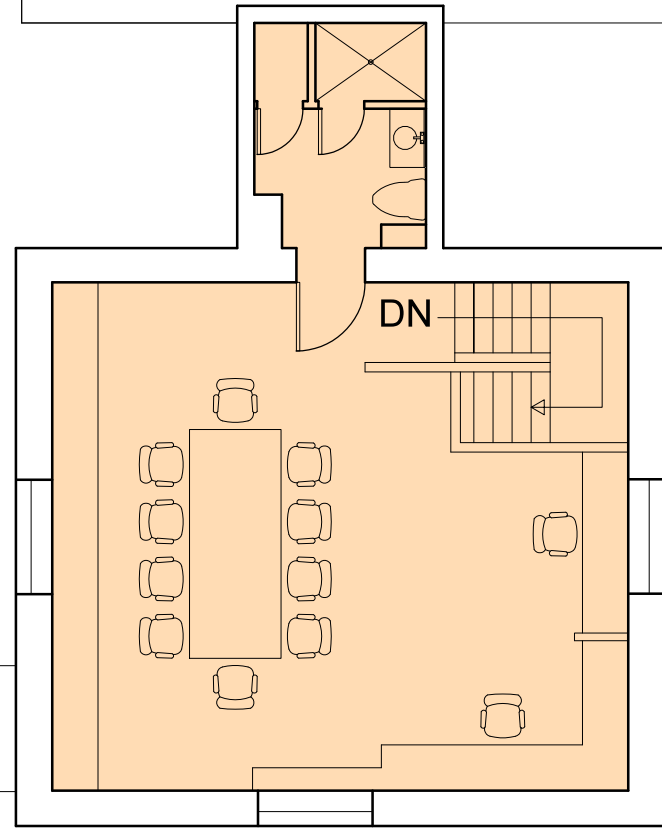

7th Floor

AS BUILT LAYOUT

Not to Scale. All dimensions and conditions are approximate and for information only.

